REVISIONS				
REV	DESCRIPTION	DATE	DRAWN	APPR
0	AS BUILT	03/08/13	SS	SS

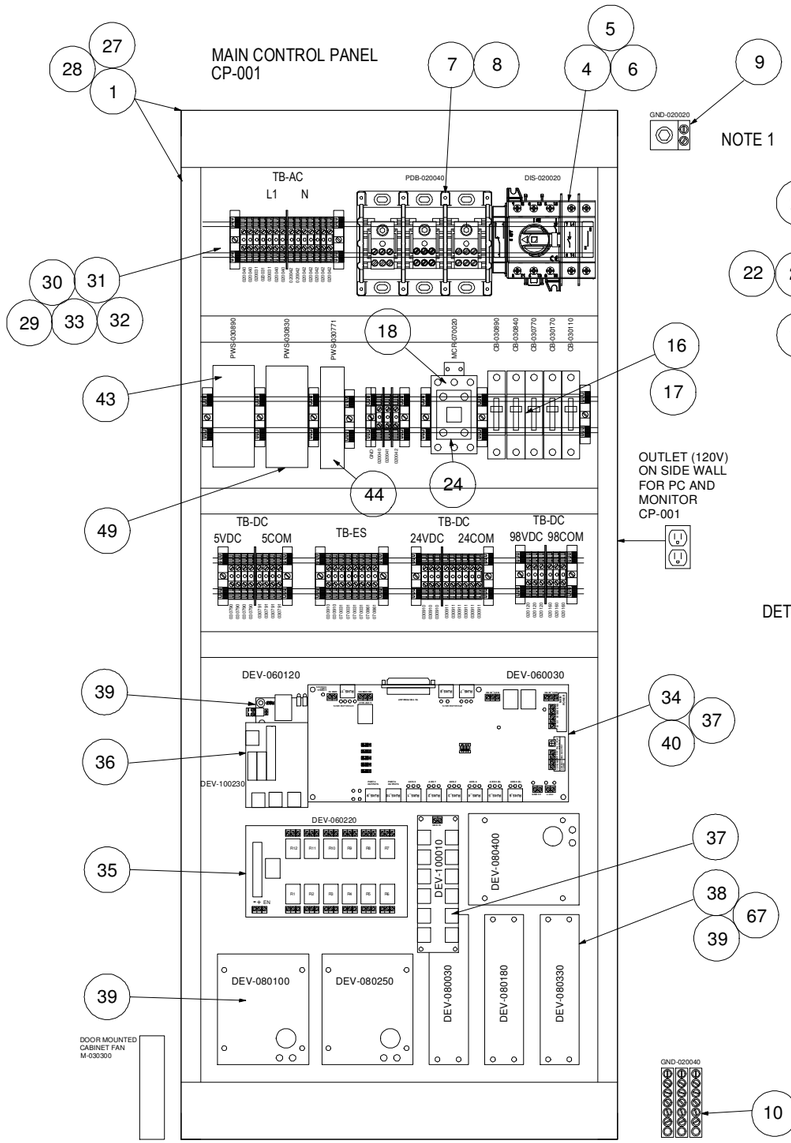

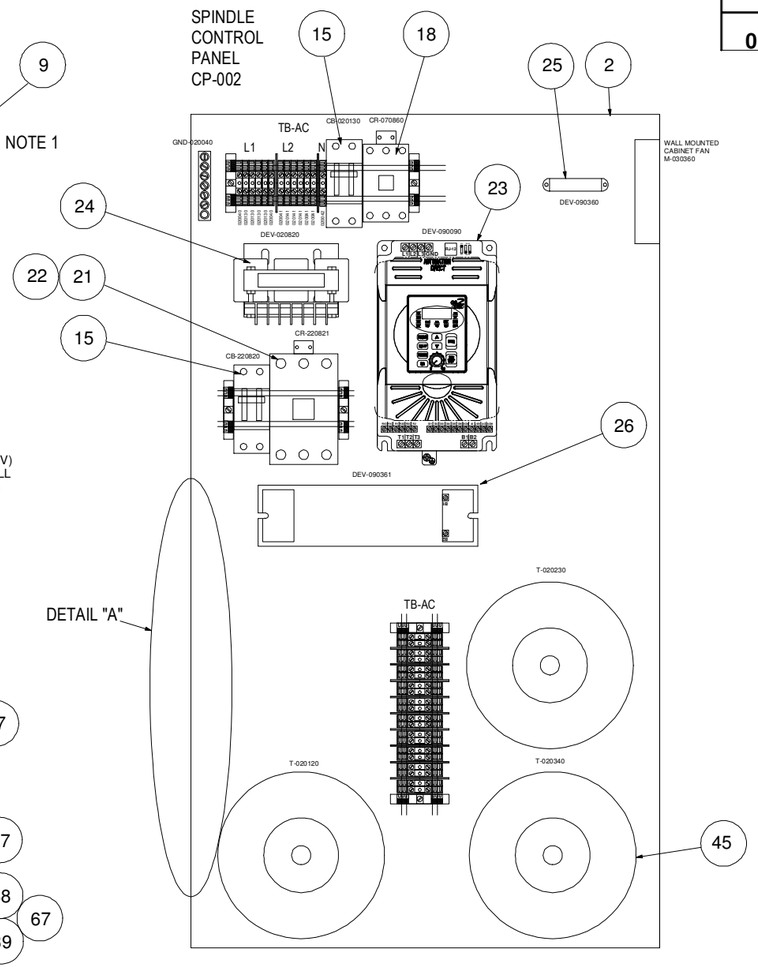

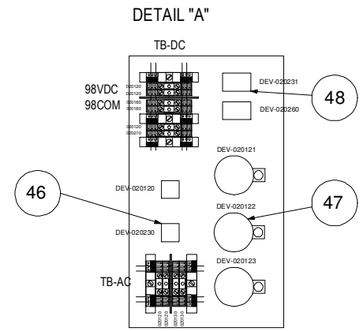

SMOOTHING CIRCUIT MOUNTED ON LEFT SIDE WALL OF CP-002

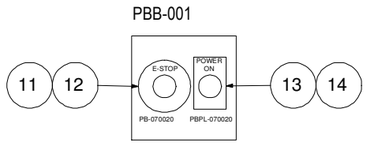

CONTROL PUSH BUTTON BOX

NOTES

1. GROUND LUG, AND 3 BARS ARE MOUNTED TO SIDE OR BOTTOM OF CABINET

UNLESS OTHERWISE SPECIFIED	SIGNATURES		DATE
DIMENSIONS ARE IN INCHES TOLERANCES ON: 2 PL DECIMALS +/- 3 PL DECIMALS +/- ANGLES +/- FRACTIONS +/-	DRAWN	SS	03/06/13
	CHECKED	SS	03/07/13
	APPROVED	SS	03/08/13
	PROJ ENGR	SS	
	PROJ MGR	SS	
	USE CLIENT DWG NO	N/A	

THIS DRAWING CONTAINS PROPRIETARY INFORMATION WHICH IS TO BE HELD CONFIDENTIAL AND MAY NOT BE REPRODUCED OR DISCLOSED TO OTHERS WITHOUT THE PRIOR WRITTEN CONSENT OF S S SYSTEMS, LLC OR DULY AUTHORIZED REPRESENTATIVE THEREOF.

S S SYSTEMS, LLC
P.O. Box 235, 269 Church House Hill Lane, Briceville, TN 37710 (865) 426-9728

CLIENT NAME WITHHELD
BRIDGE PORT SERIES II CNC RETROFIT
CONTROL PANEL LAYOUT

SIZE	CAGE CODE	DWG NO.	REV
D	n/a	13SS010-ENC-110	0

SCALE	PROJECT NO.	SHEET	OF
n/a	13SS010	9	10